

Fort Hays State University

FHSU Scholars Repository

Rarick Hall

Buildings & Facilities

November 1977

Letter, to W.E. Sanneman, from Earl G. Bozeman, November 29, 1977

Earl G. Bozeman

Follow this and additional works at: <https://scholars.fhsu.edu/rarick>

Recommended Citation

Bozeman, Earl G., "Letter, to W.E. Sanneman, from Earl G. Bozeman, November 29, 1977" (1977). *Rarick Hall*. 25.

<https://scholars.fhsu.edu/rarick/25>

This Document is brought to you for free and open access by the Buildings & Facilities at FHSU Scholars Repository. It has been accepted for inclusion in Rarick Hall by an authorized administrator of FHSU Scholars Repository.

FORT HAYS STATE UNIVERSITY
~~XX~~
~~FORT HAYS KANSAS STATE COLLEGE~~

Earl G. Bozeman, AIA

HAYS, KANSAS 67601

Director of Planning and Development

913 628-4423



November 29, 1977

Mr. W. E. Sanneman
Architectural Services Division
State Office Building
Topeka, Kansas

Re: CCR: A-3314
Demolition and Removal of Rarick Hall
Fort Hays State University
Hays, Kansas

Dear Mr. Sanneman:


Enclosed is an 8-1/2 x 11 drawing of a Plot Plan of Rarick Hall, which I suggest be forwarded to all bidders as part of Addendum #2. This plan covers information that should be available to all bidders with regard to extent of area of demolition and removal, existing utilities, and general information for size and height of building.

Please issue additional information in this addendum:


1. Contractor shall remove and return to Owner, the existing cornerstone located at the northeast corner of the building.
2. Owner will remove the 2 existing 5" thick x 26" wide x 64" long stone slabs at each side of the entrance steps to the building.
3. Owner will have removed all furniture and equipment from the building prior to start of demolition work by the contractor. (I don't believe the specs indicated whether or not the furniture would remain or be removed by the Owner. At least, one contractor inquired about the furniture.)
4. Include as an ADD ALTERNATE: Contractor shall remove without damage, clean for reuse, and store on site, seventy-five (75) of the facing stones of a size ranging from 8-1/2" high x 20" or longer. In cooperation with the contractor, Owner will load and remove the 75 stones from the site. ADD \$_____.

I believe that you can probably get this Addendum out to the bidders in adequate time prior to the bid date of December 8, 1977.

Sincerely yours,

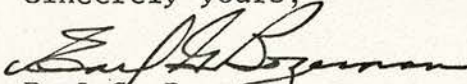
Earl G. Bozeman

cc: President G.W. Tomanek ✓
Walter Keating

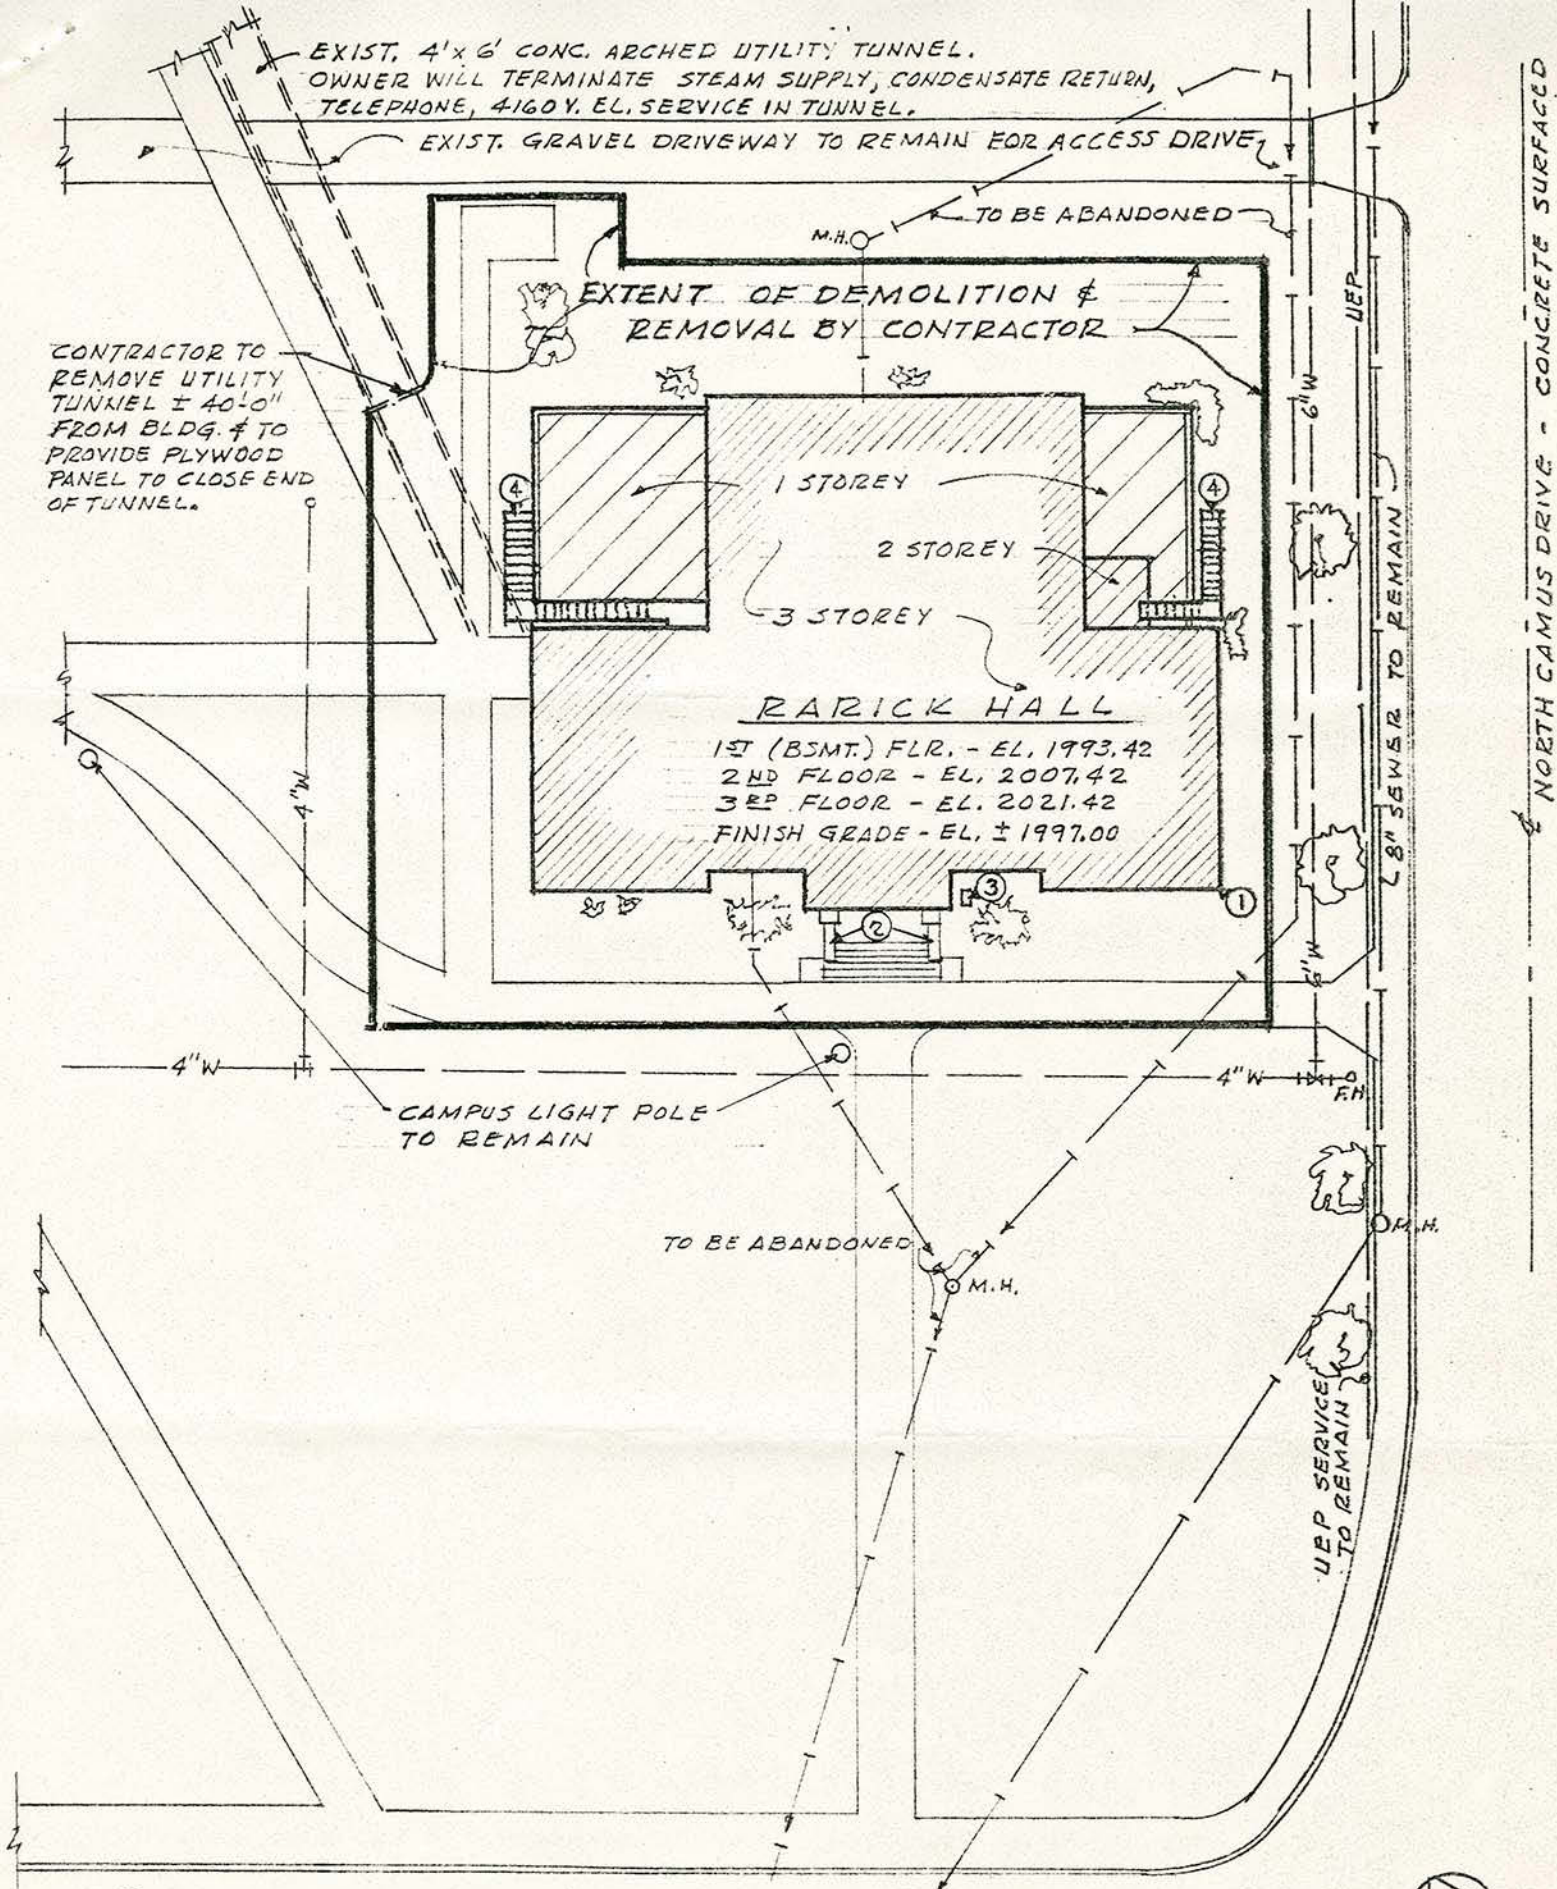

- ① CONTRACTOR TO REMOVE & RETURN CORNERSTONE TO OWNER.
- ② OWNER TO REMOVE STONE SLABS.
- ③ OWNER TO REMOVE AIR COND. UNIT.
- ④ OWNER TO REMOVE STEEL FIRE-ESCAPES.

PART OF ADDENDUM # 2

PLOT PLAN RARICK HALL

SCALE 1" = 30'-0"

FORT HAYS STATE UNIVERSITY
HAYS, KANSAS CCR:A-3314
EGB 11-29-77